

Drawing Title
---------------

THIRD FLOOR

Project Title

ARCHITECTURAL

Approved: Project Section Chief

Approved: Division Chief

Approved: Facility Director

Location  
JAMES A. HALEY VETERANS' HOSPITAL  
13000 BRUCE B. DOWNS BLVD.

Drawn

MWR	10/2
Printed	Printed

Page 10 of 10

Bldg #	DRAWING NO.
1	


1AS12.3

File Number 170120


Dwg. 1 Of 1



Revisions	Date
3 SOUTH MODIFICATIONS	11-20-12

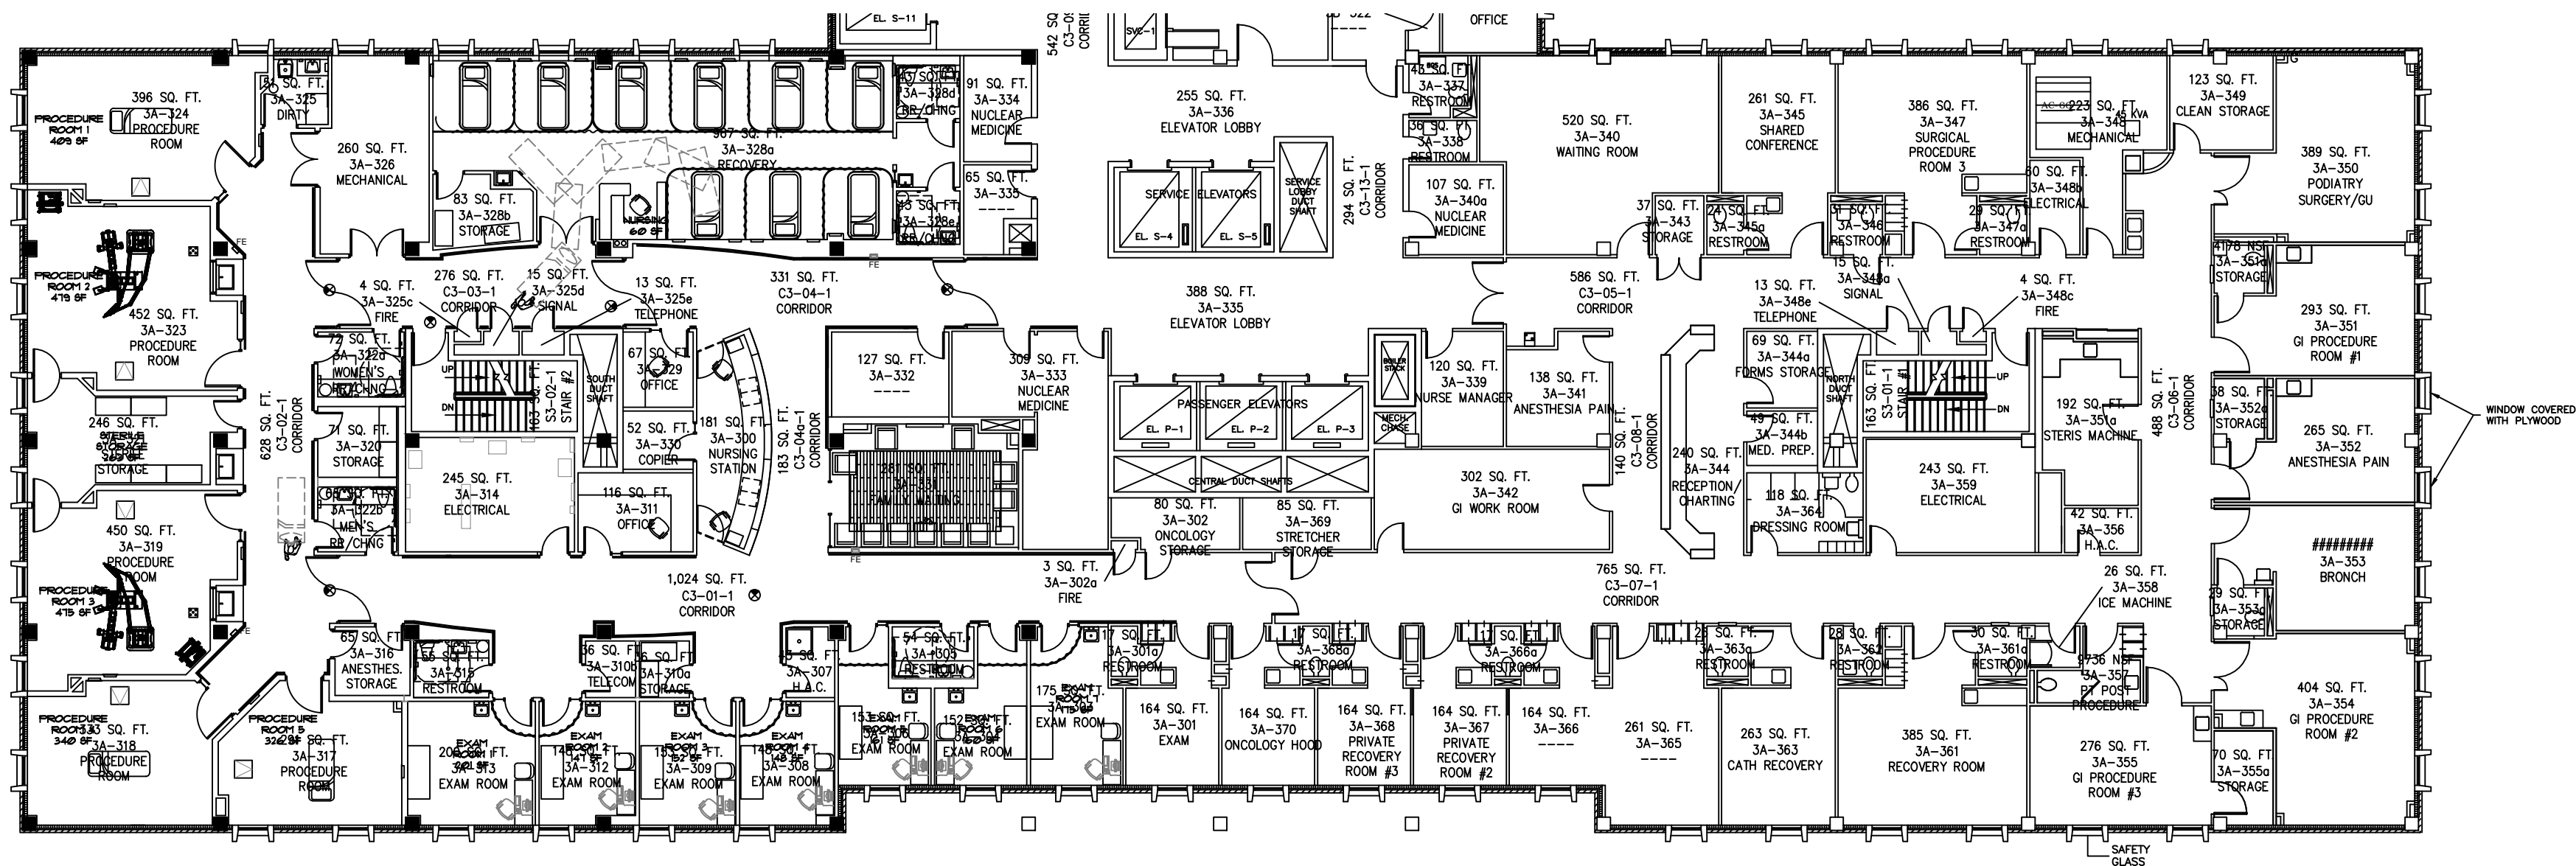

THIRD FLOOR WING A  
SCALE: 1/16" = 1'-0"

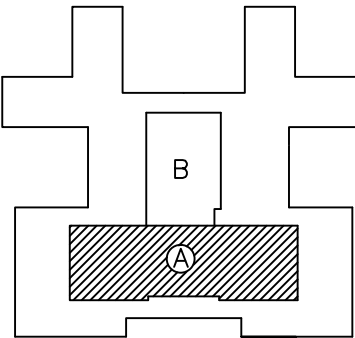


Drawing Title	
THIRD FLOOR WING A	
Project Title	
ARCHITECTURAL	
Approved: Project Section Chief	
Approved: Service Chief	
Approved: Facility Director	
Location: JAMES A. HALEY VETERANS' HOSPITAL 13000 BRUCE B. DOWNS BLVD. TAMPA, FLORIDA 33612	
Drawn	Date
MWK	07/12/05
Checked	Project No.
Building Number	DRAWING NO.
1	1AS124
File Number	Dwg. Of
Office of Facilities	
Department of Veterans Affairs	

# ARCHITECTURAL KEYNOTES


1. GMS/GWB FRAMED PARTIAL HEIGHT WALLS AND COUNTERTOP TO BE USED AS A UTILITY CHASE AT PATIENT CARE AREAS. REFER TO A17 AND A18 SHEETS FOR ADDITIONAL INFORMATION.
2. FULL HEIGHT (7'-0") CASEWORK FOR SUPPLY STORAGE WITH SLOPED TOP.
3. PROVIDE 5" HIGH CONTINUOUS CONCRETE CONTAINMENT CURB AT PERIMETER OF R.O. WATER TREATMENT ROOM 2B-241 AS INDICATED ON PLANS. REFER TO STRUCTURAL DRAWINGS FOR ADDITIONAL INFORMATION.
4. PROVIDE 3/4" PLYWOOD SHEATHING WITH FIRE RETARDENT PAINT ON ALL PERIMETER WALLS OF R.O. TREATMENT ROOM 2B-241 TO A MIN HEIGHT OF 8'-0" AFF.
5. PROVIDE GMS/SHEATHING/STUCCO INFILL WHERE WINDOWS ARE REMOVED IN R.O. TREATMENT ROOM 2B-241. REFER TO STRUCTURAL FOR RELATED WIND LOADS AND DETAIL ON THIS SHEET FOR ADDITIONAL INFORMATION.
6. DASHED LINES INDICATE LOCATION OF NEW DOOR AND WALLS TO BE PROVIDED AND INSTALLED BY OTHERS AS PART OF A SEPARATE RENOVATION PROJECT. THIS INFORMATION IS INCLUDED FOR REFERENCE ONLY TO COORDINATE THE LOCATION AND INSTALLATION OF THE NEW CROSS CORRIDOR DOOR. THE CONTRACTOR SHALL VERIFY THE EXACT LOCATION IN THE FIELD WITH THE PARTICIPATION OF VA STAFF TO AVOID CONFLICT WITH THE ADJACENT RENOVATION.
7. OBSERVATION WINDOW. SEE DETAILS ON SHEET A14.1 FOR ADDITIONAL INFORMATION.
8. REFER TO STRUCTURAL DRAWINGS FOR REQUIRED STRUCTURAL REINFORCING TO FLOOR OF R.O. WATER TREATMENT ROOM 2B-241. PROVIDE FIREPROOFING TO MATCH EXISTING REQUIRED RATING OF FLOOR. PATCH ANY EXISTING FIREPROOFING DAMAGED AS A RESULT OF CONSTRUCTION ACTIVITIES.
9. STC 55 WALLS - BASIS OF DESIGN ASSUMES UL DESIGN NUMBER U465: BASE LAYER 5/8" SOUNDBREAK XP GYPSUM BOARD VERTICALLY APPLIED TO 3-5/8" STEEL STUDS SPACED 24" O.C. WITH 1" TYPE S SCREWS 24" O.C. FACE LAYER 5/8" FIRE-SHIELD GYPSUM BOARD VERTICALLY APPLIED WITH 1-5/8" TYPE S SCREWS 12" O.C. OPPOSITE SIDE 5/8" FIRE-SHIELD BOARD VERTICALLY APPLIED WITH 1" TYPE S SCREWS 12" O.C. VERTICAL JOINTS STAGGERED 24" EACH LAYER AND OPPOSITE SIDES. 3-1/2" GLASS FIBER IN STUD CAVITY. PER ACOUSTIC TEST RAL TL06-334.

# FLOOR PLAN NOTES

1. FIRE RESISTANCE - MAINTAIN INTEGRITY OF EXISTING FIRE AND/OR SMOKE PARTITIONS THROUGHOUT, UNLESS NOTED OTHERWISE. MAINTAIN INTEGRITY OF ALL EXISTING FIREPROOFING, FIRESTOPPING, COLUMN ENCLOSURES, ETC. TO ENSURE FIRE RESISTANCE MEETS OR EXCEEDS THAT ORIGINALLY REQUIRED OR SPECIFIED. PATCH ALL AREAS DAMAGED OR REMOVED DUE TO NEW CONSTRUCTION TO MATCH THAT OF THE EXISTING OR AS REQUIRED FOR NEW.
2. FIRE EXTINGUISHERS - ALL EXISTING EXTINGUISHERS SHALL BE CLEANED AND RECERTIFIED PRIOR TO RELOCATION.
3. EXISTING SYSTEMS - ALL EXISTING SYSTEMS SUCH AS ALARMS, ELECTRICITY, WATER, SPRINKLERS, ETC. SHALL REMAIN ACTIVE AT ALL TIMES DURING DEMOLITION & CONSTRUCTION. ANY EXCEPTION TO THIS SHALL BE COORDINATED WITH THE OWNER AND ARCHITECT.
4. FINISHES - ALL EXISTING FINISHES SHALL REMAIN, UNLESS SCHEDULED FOR NEW. CONTINUE EXISTING FINISHES TO REMAIN INTO NEW EXTENDED AREAS THAT ARE ADJACENT. PATCH & REPAIR EXISTING TO MATCH NEW. PREPARE SUBSTRATES TO RECEIVE NEW FINISHES WHERE SCHEDULED. FINISH ALL PATCHED OR EXTENDED WALLS TO NEAREST CHANGE OF DIRECTION, WALL TERMINATION, OR INTERSECTION.
5. CONFLICTS - ANY CONFLICT FOUND WITH EXISTING CONDITIONS AND REQUIREMENTS FOR NEW CONSTRUCTION SHALL BE IMMEDIATELY BROUGHT TO THE ATTENTION OF THE ARCHITECT. IF THE CONFLICT AFFECTS THE PROGRESS OF THE WORK, VERIFY WITH ARCHITECT SOLUTION NECESSARY PRIOR TO PROCEEDING WITH THAT PORTION OF THE WORK AND IN A TIMELY FASHION SO AS NOT TO DELAY THE WORK. COORDINATE ALL TRADES TO ASCERTAIN NO FURTHER WORK WILL BE IMPACTED BY THE CONFLICT, OR ITS SOLUTION.
6. FLOORS - CONTRACTOR SHALL FIELD VERIFY LEVELNESS OF EXISTING FLOOR SLABS AFTER COMPLETION OF DEMOLITION WORK AND BRING TO THE ARCHITECT'S ATTENTION ANY DEVIATION FROM SPECIFIED TOLERANCES. ANY CORRECTIVE WORK SHALL BE ACCOMPLISHED PRIOR TO NEW CONSTRUCTION. (\*\*NOTE TO PROJECT ARCHITECT -NOTE ON DRAWINGS ANY AREAS/QUANTITY OF KNOWN CORRECTIVE WORK REQUIRED\*\*)
7. SEALED OPENINGS - WHERE OPENINGS ARE CREATED IN EXISTING CONSTRUCTION SCHEDULED TO REMAIN (SUCH AS REMOVAL OF DOORS OR WINDOWS IN EXISTING WALLS TO REMAIN), REMOVAL OF DOORS OR WINDOWS IN EXISTING WALLS TO REMAIN), FURNISH AND INSTALL NEW CONSTRUCTION OF TYPE AND THICKNESS TO MATCH THE EXISTING WALL THICKNESS AND RATING, IF ANY. FINISH SUCH SEALED OPENINGS TO MATCH THE EXISTING UNLESS NEW FINISHES ARE SCHEDULED FOR THOSE SURFACES.
8. EXISTING CONSTRUCTION - ALL EXISTING SURFACES TO REMAIN WITHIN CONSTRUCTION LIMITS SHALL BE PATCHED AND REPAIRED AT AREAS WHERE DEMOLITION WORK HAS OCCURRED TO UPGRADE TO A CONDITION THAT MATCHES THE EXISTING ADJACENT CONSTRUCTION. EXISTING WALLS THAT CONTAIN PLUMBING, ELECTRICAL OR OTHER SERVICES REQUIRING MODIFICATION SHALL BE CUT BACK TO THE NEAREST STUD TO ALLOW REQUIRED WORK. AFTER COMPLETION, RECONSTRUCT TO A CONDITION THAT MATCHES NEW CONSTRUCTION, FLUSH WITH ADJACENT SURFACES. EXISTING FLOORS WHERE CONSTRUCTION HAS BEEN REMOVED SHALL BE PATCHED AND LEVELED TO MATCH THE EXISTING.

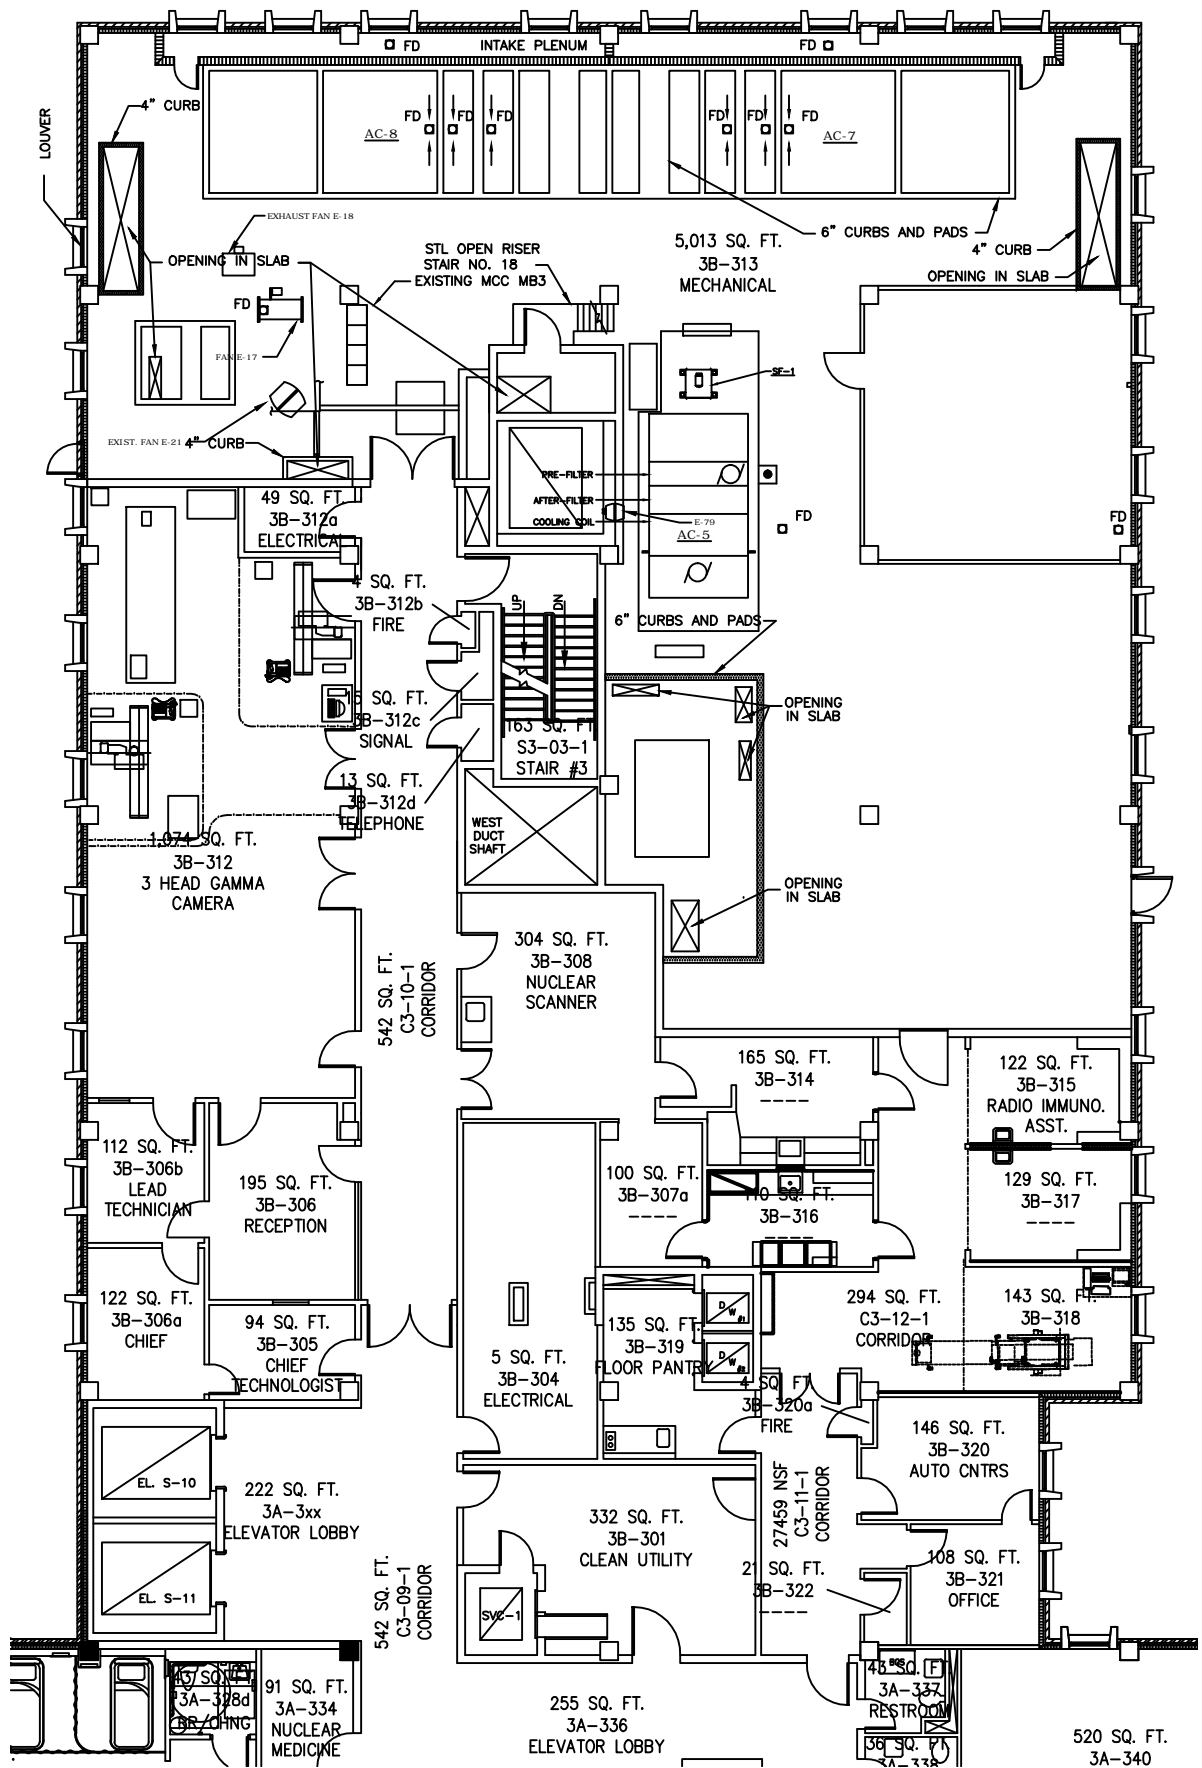

THIRD FLOOR WING B  
SCALE: 1/16" = 1'-0"

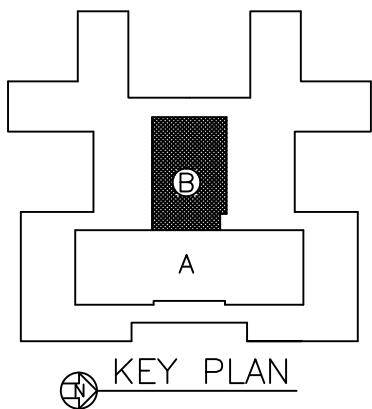

Revisions	Date
08-105 RECORD DRAWINGS	12-05-11

Drawing Title  
  
THIRD FLOOR  
WING B

Project Title  
  
ARCHITECTURAL

Approved: Project Section Chief

Approved: Service Chief

Approved: Facility Director

LocationJAMES A. HALEY VETERANS' HOSPITAL  
13000 BRUCE B. DOWNS BLVD.  
TAMPA, FLORIDA 33612

Drawn  
Date  
MWK  
03/08/04

Checked  
Project No.

Building Number  
1  
DRAWING NO.  
1AS125

File Number  
Dwg. Of

